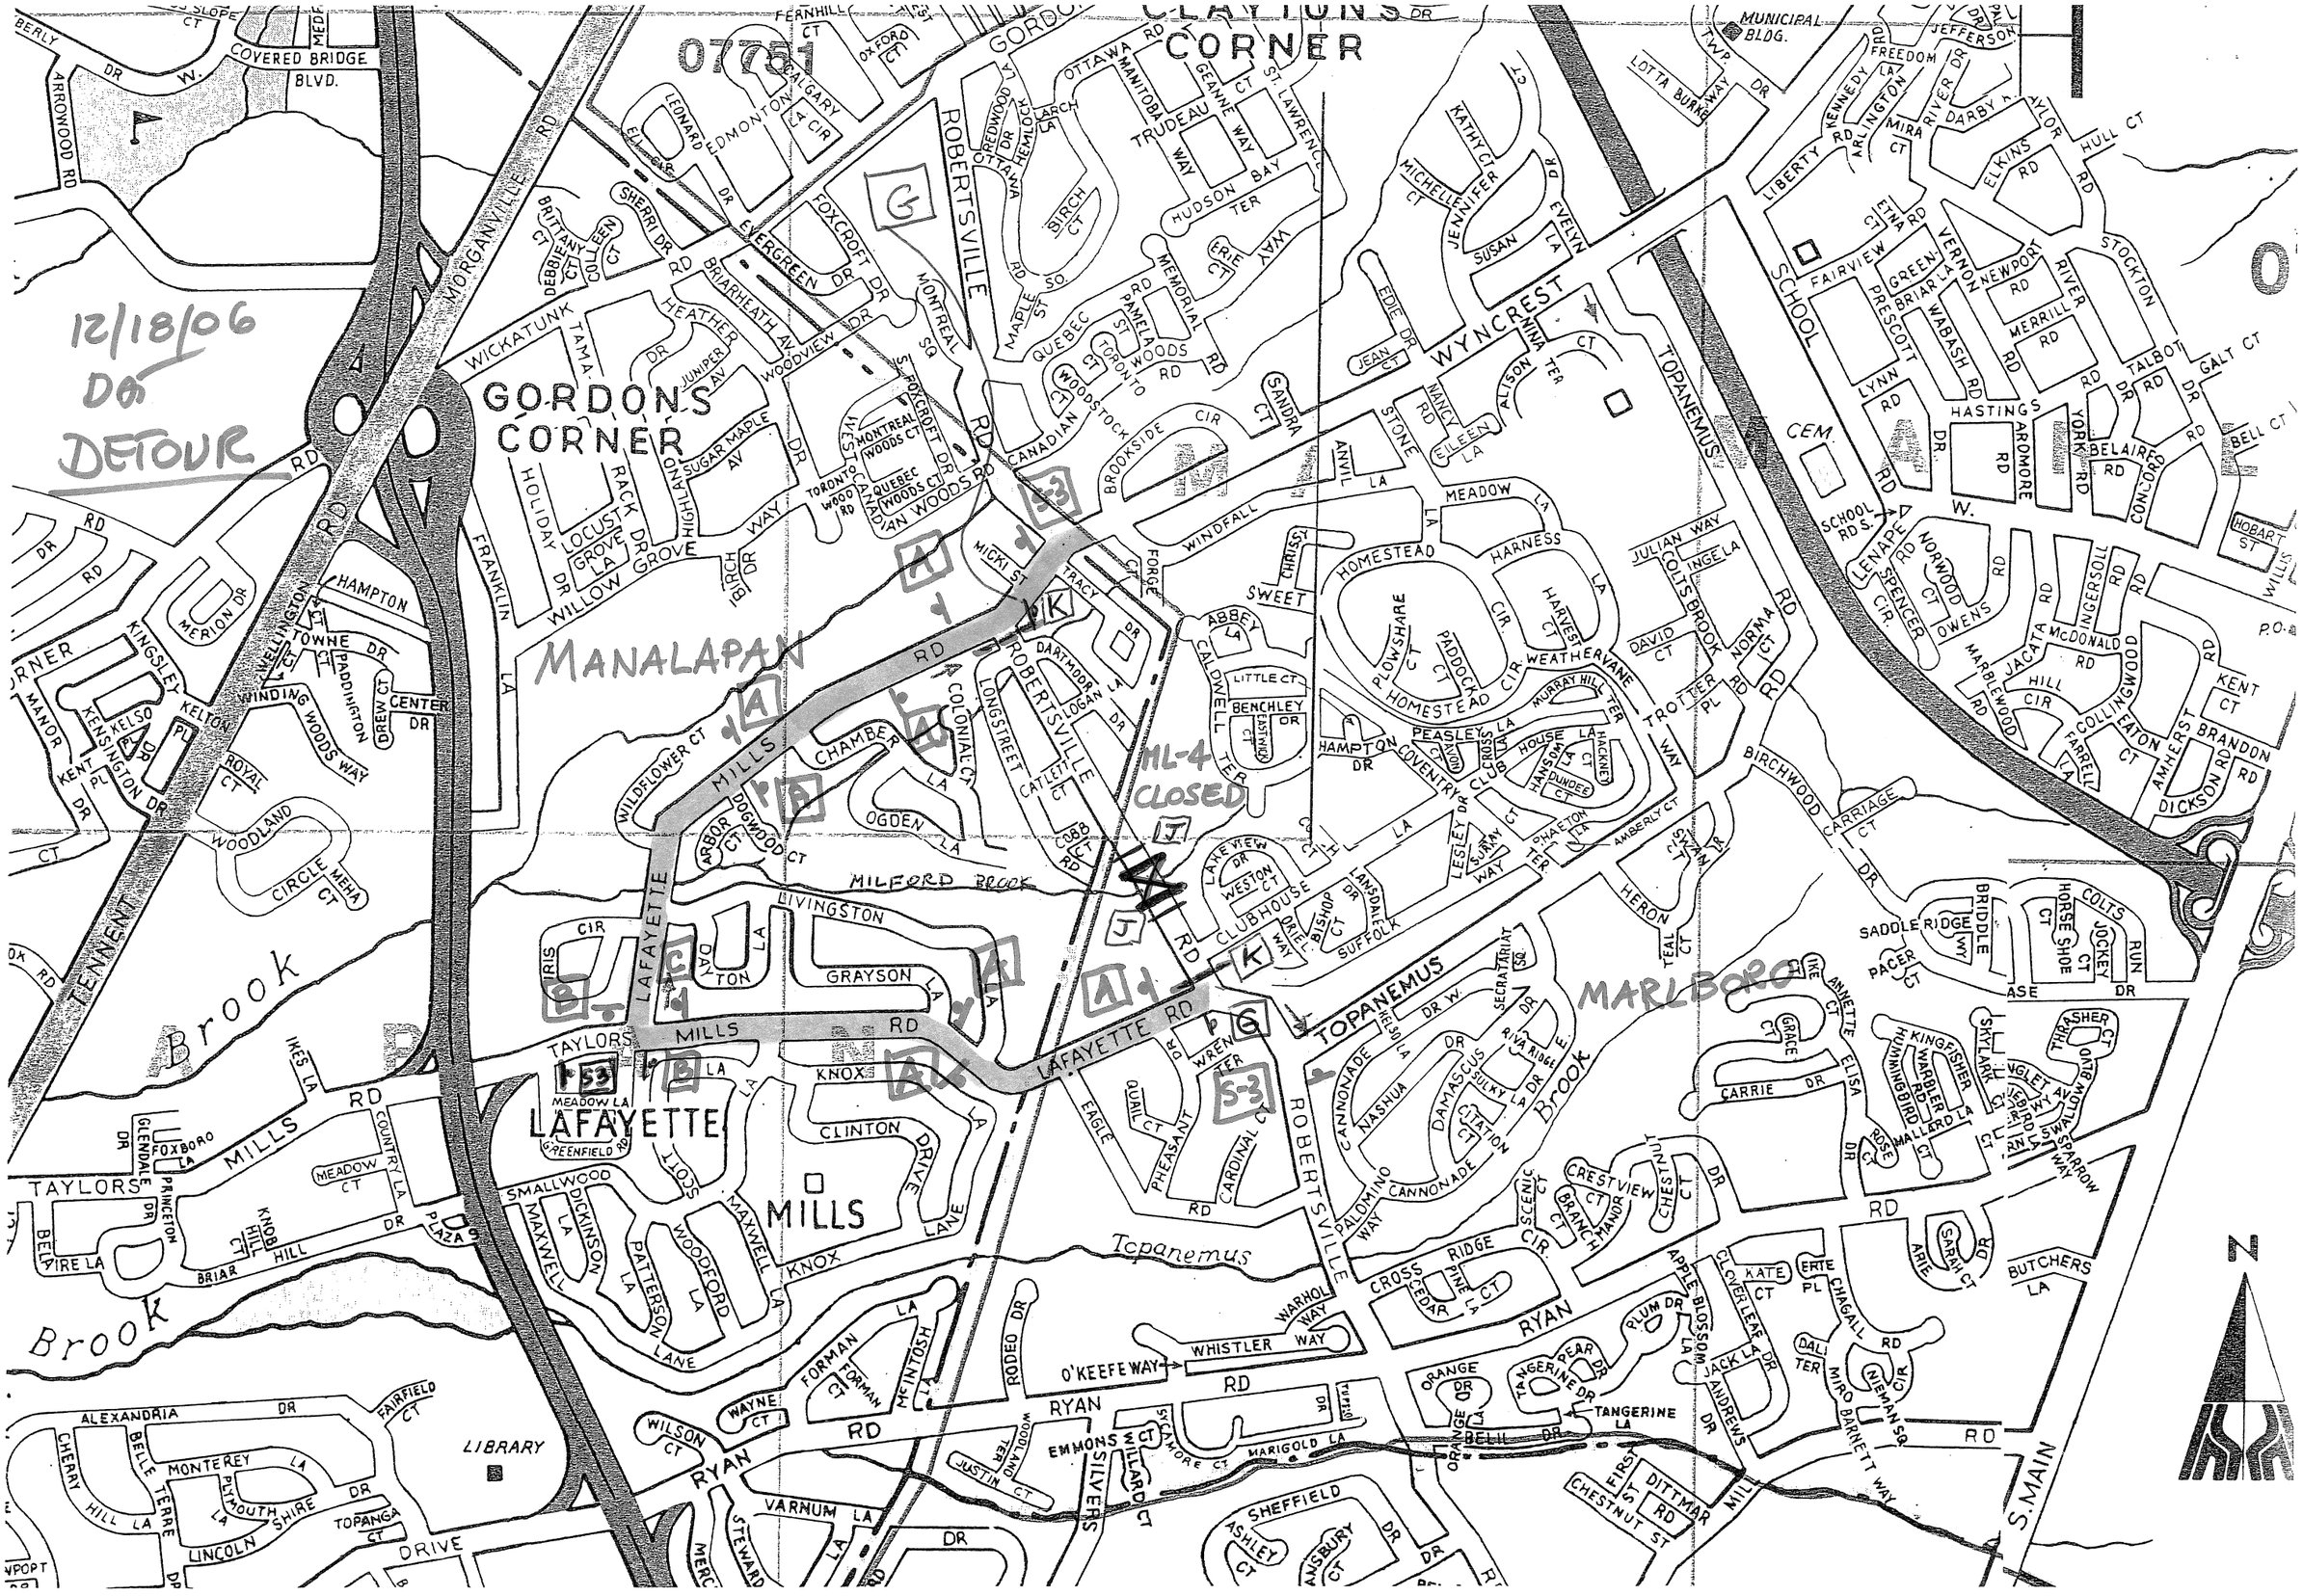
12/18/06
DO
DETOUR
07751
CLAYTONS CORNER
GORDONS CORNER
MANALAPAN
MILLS
LAFAYETTE
MARLBORO
WYNCREST
TOPANEMUS
ROBERTSVILLE
MORGANVILLE RD
MILLS RD
LAFAYETTE RD
RYAN RD
S. MAIN
SCHOOL RD
MUNICIPAL BLDG.
LIBRARY
CEM.
ML-4 CLOSED
Brook
Topanemus
TENNENT
N

12/18/06

SIGN	DESIGN	TYPE	SIZE	NO. REQ'D
A	DETOUR ↑	M4-9X	30"x24"	~~15~~ 7
B	DETOUR ←	M4-9L	30"x24"	~~1~~ 2
C	DETOUR →	M4-9R	30"x24"	~~4~~ 1
D	DETOUR →	M4-10R	48"x18"	1
G	END DETOUR	M4-8A	30"x24"	2
H	ROAD CLOSED AHEAD	W20-3	48"x48"	1
J	BRIDGE CLOSED	R11-2	48"x30"	2
K	BRIDGE OUT AHEAD LOCAL TRAFFIC ONLY	R11-3	60"x30"	2
L	DETOUR 1500 FT	W20-2	48"x48"	2
M	DETOUR 1000 FT	W20-2	48"x48"	2
N	DETOUR 500 FT	W20-2	48"x48"	2
O	← DETOUR	M4-10L	48"x18"	1
S-1	STREET NAME ~~LOCUST AVENUE~~ ROBERTSVILLE (RD)	M4-9N	12"x30"	~~18~~ 3 MIN
S-2	~~ON OR ABOUT (DATE) THIS BRIDGE TO BE CLOSED / PLAN ALT. ROUTE~~ 4" C 6" C 8" C 1" C 6" C		84"x48"	2
S-3	~~LOCUST AVENUE~~ ROBERTSVILLE (RD) BRIDGE CLOSED FOLLOW DETOUR 6" C 5" C 4" C		60"x30"	~~8~~ 3
S-4	MONMOUTH COUNTY PROJECT SIGN (SEE DETAIL SHEET NO. 76)		60"x48"	2